COUNTY OF SAN DIEGO TRACT N

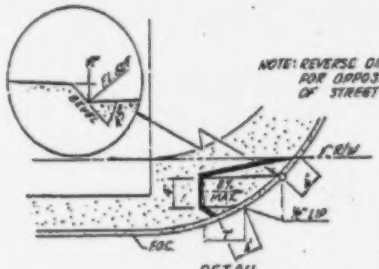

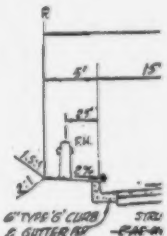

SPACE 335

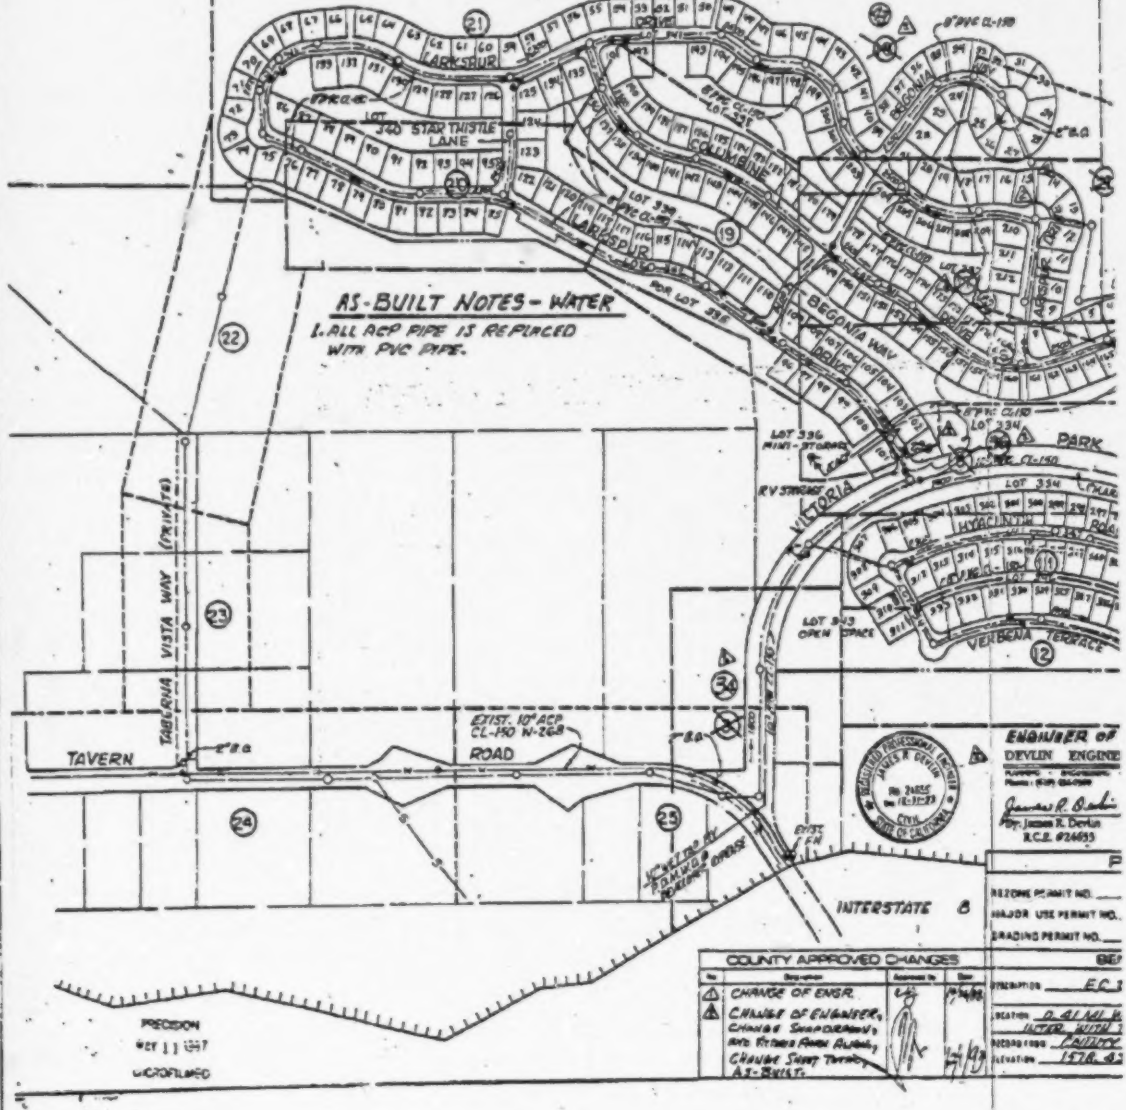

ENGINEER OF
DEVLIN ENGINE
By: James R. Devlin
R.C.E. #24693

COUNTY APPROVED CHANGES

No.	Description	Approved by	Date
1	CHANGE OF ENGR.		
2	CHANGE OF ENGINEER, CHANGE SHADEBRANCH'S INTO RITNER AVEN. BLOCK, CHANGE SHEET TWENTY AS-BUILT.		

REZONE PERMIT NO.
MAJOR USE PERMIT NO.
GRADING PERMIT NO.

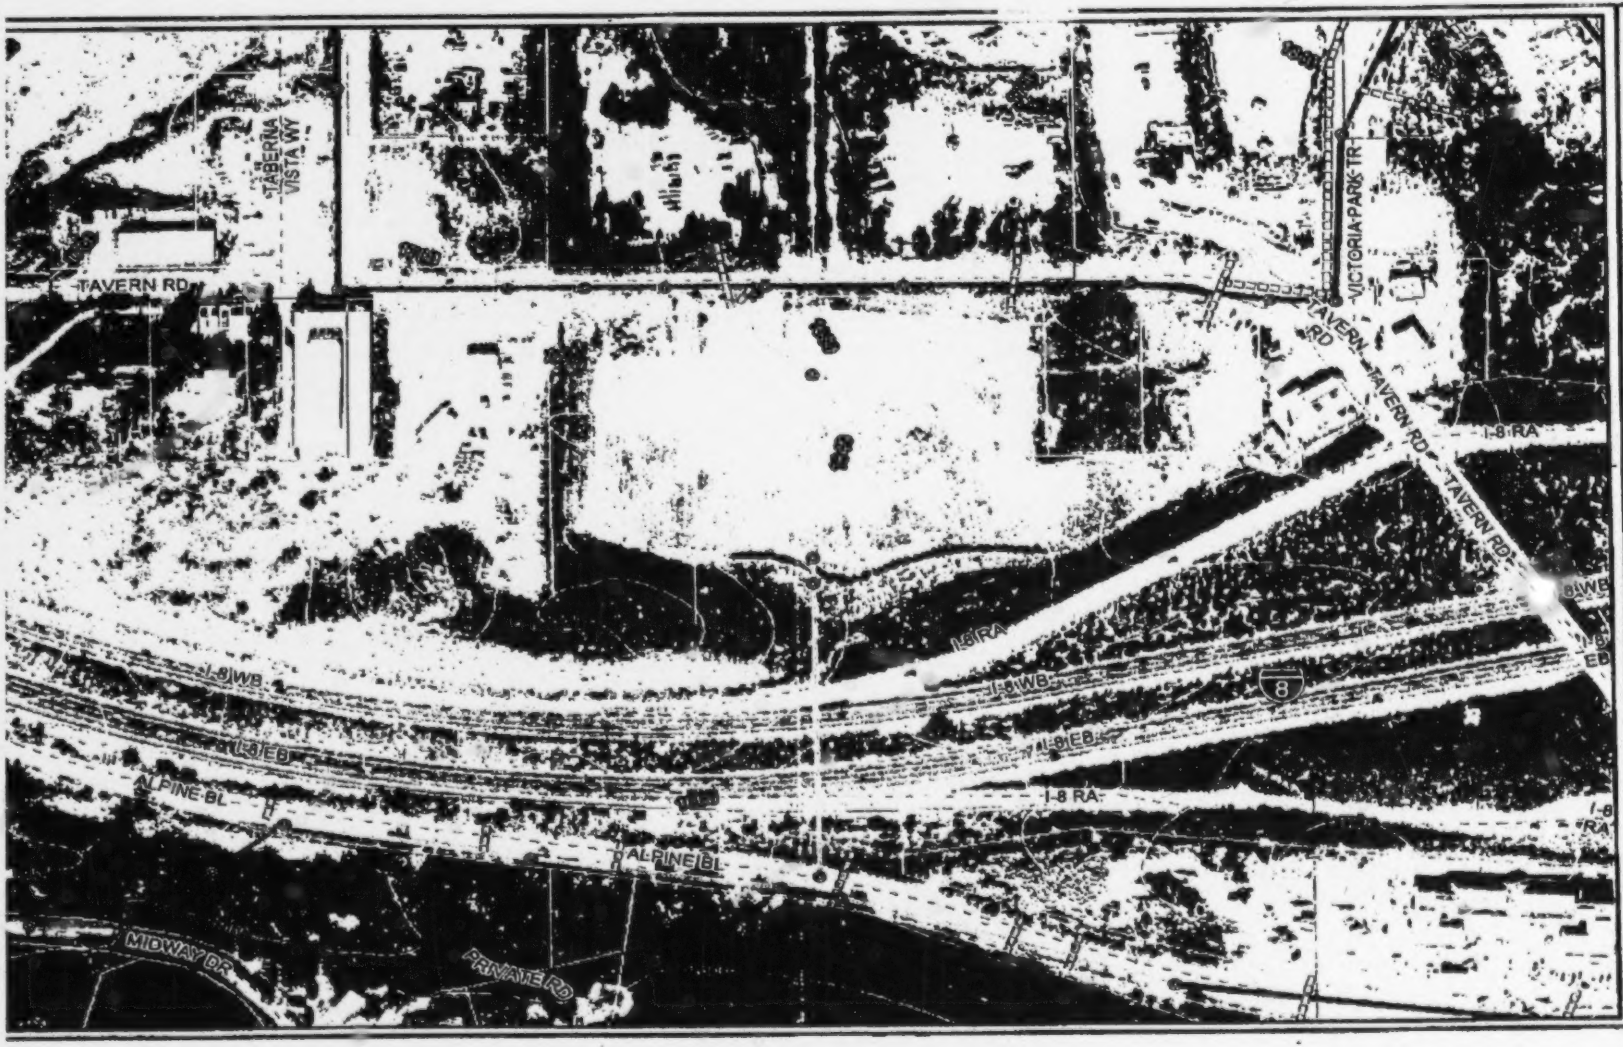
TAVERN RD
TABERNA VISTA WY
VICTORIA PARK TR
TAVERN RD
TAVERN RD
TAVERN RD
I-8 RA
I-8 WB
I-8 EB
I-8 RA
I-8 WB
I-8 EB
I-8 RA
ALPINE BL
ALPINE BL
MIDWAY DR
PRIVATE RD
8
Alpine
Sanitation District
1"=300'

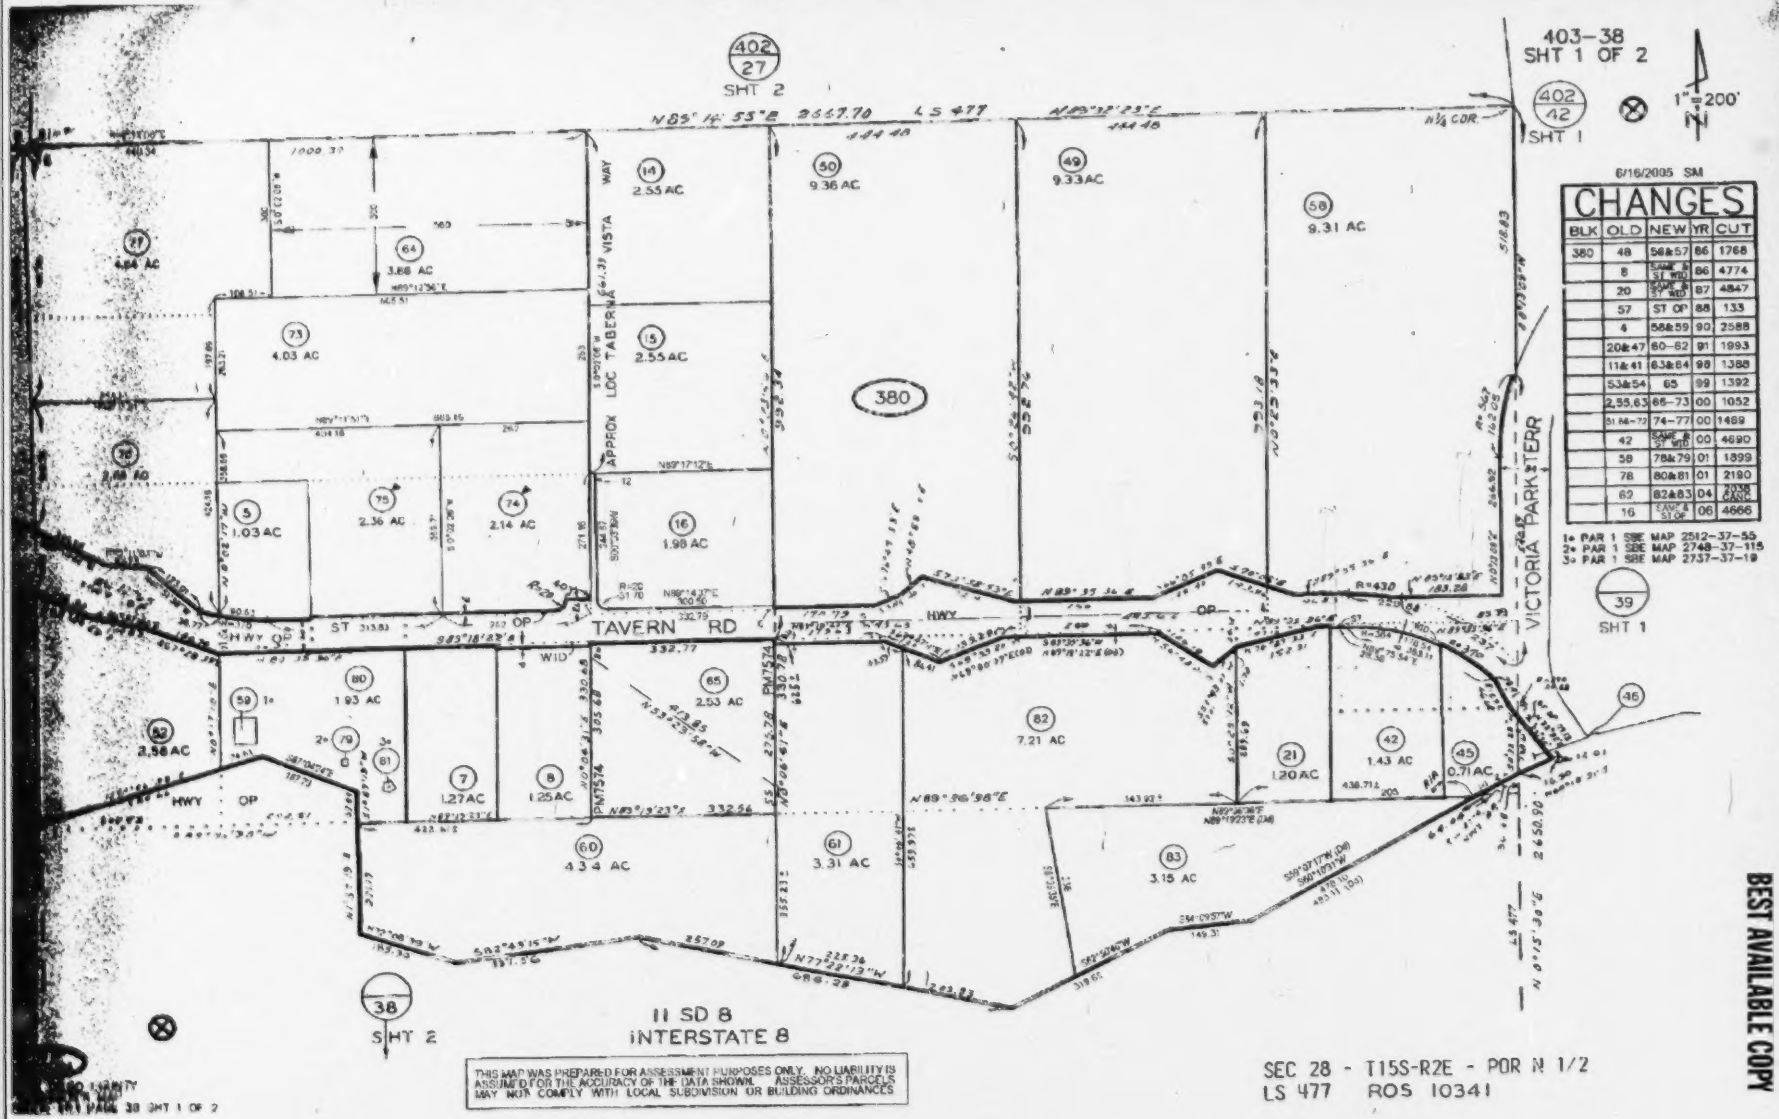
403-38
SHT 1 OF 2
402
27
SHT 2
402
42
SHT 1
1" = 200'
N
6/16/2005 SM
CHANGES
BLK | OLD | NEW | YR | CUT
380 | 48 | 56&57 | 86 | 1768
8 | SAME & ST WID | 86 | 4774
20 | SAME & ST WID | 87 | 4847
57 | ST OP | 88 | 133
4 | 58&59 | 90 | 2588
20&47 | 60-62 | 91 | 1993
11&41 | 63&64 | 98 | 1388
53&54 | 65 | 99 | 1392
2,55,63 | 66-73 | 00 | 1052
51,66-72 | 74-77 | 00 | 1489
42 | SAME & ST WID | 00 | 4690
58 | 78&79 | 01 | 1899
78 | 80&81 | 01 | 2190
62 | 82&83 | 04 | 2058 ASCE
16 | CANC & ST OP | 06 | 4666
1= PAR 1 SRE MAP 2512-37-55
2= PAR 1 SRE MAP 2748-37-115
3= PAR 1 SRE MAP 2737-37-19
39
SHT 1
380
TAVERN RD
VICTORIA PARK TERR
APPROX LOC TABERNA VISTA WAY
HWY OP
ST OP
WID
N89°14'55"E 2657.70 LS 477
N1/4 COR
1.03 AC
2.36 AC
2.14 AC
1.98 AC
2.55 AC
2.55 AC
9.36 AC
9.33 AC
9.31 AC
4.03 AC
3.88 AC
4.84 AC
2.58 AC
1.93 AC
2.53 AC
7.21 AC
1.20 AC
1.43 AC
0.71 AC
1.27 AC
1.25 AC
4.34 AC
3.31 AC
3.15 AC
II SD 8
INTERSTATE 8
38
SHT 2
THIS MAP WAS PREPARED FOR ASSESSMENT PURPOSES ONLY. NO LIABILITY IS ASSUMED FOR THE ACCURACY OF THE DATA SHOWN. ASSESSOR'S PARCELS MAY NOT COMPLY WITH LOCAL SUBDIVISION OR BUILDING ORDINANCES
SEC 28 - T15S-R2E - POR N 1/2
LS 477 ROS 10341
BEST AVAILABLE COPY

```
 AS01P002                  Parcel Detail Screen 1- 2007        04/27/06 14:20:56
PN: 403-380-83-00  TRA:  51070          CC Trans:          Cd: X    Tax St: T
Ctl Doc: T2003-527344   ED: 12-31-03 DD: 12-31-03 DT: 001 AD/SRC: 12-01-05 / TS
PI: 1   PANS COUNTY OF SAN DIEGO

 PUBLIC AGENCY 00000                                                    ALT
------------------------------ Property Data -------------------------------
Situs: TAVERN RD
Legal: SEC 28-15-2E*NWQ*DOC03-1527344 IN SEQ OF
Map            SE Acrg 3.15
------------------- Values and Exemptions --------------------      HCY:
       205,728 Land                      Fix                 Ex    Ex Cd
               Imps                      BPP                 Ex    Ex Cd
       205,728 L+I                       Opp                 Ex    Ex Cd
       205,728 Tot             205,728 Net
---------------------------------- Codes ----------------------------------
Appl Area: 75   VCD: 06-10-05  VAD:            S/RY:   S/RC:   Def Tx Yr:
-------------------------------- Cut Data ---------------------------------
                    PPN: 403-380-62-00     PTra: 051016
Cut#/Yr/Typ: 002038 / 2004 / CC Tra#/Yr: 005111 / 1984 Rep#/Yr:    /
Cut Doc Id:                Cut Eff Dt:          State Assmnt #:

F2> T/S            <F9> XREF <ENTER> MENU AYR _
```